



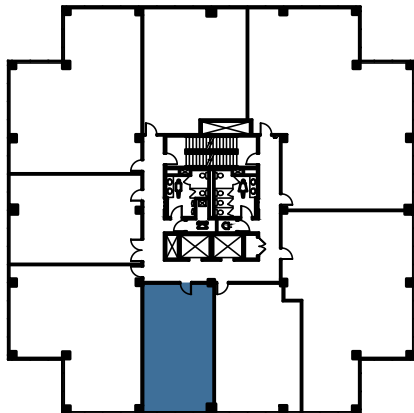

REAL

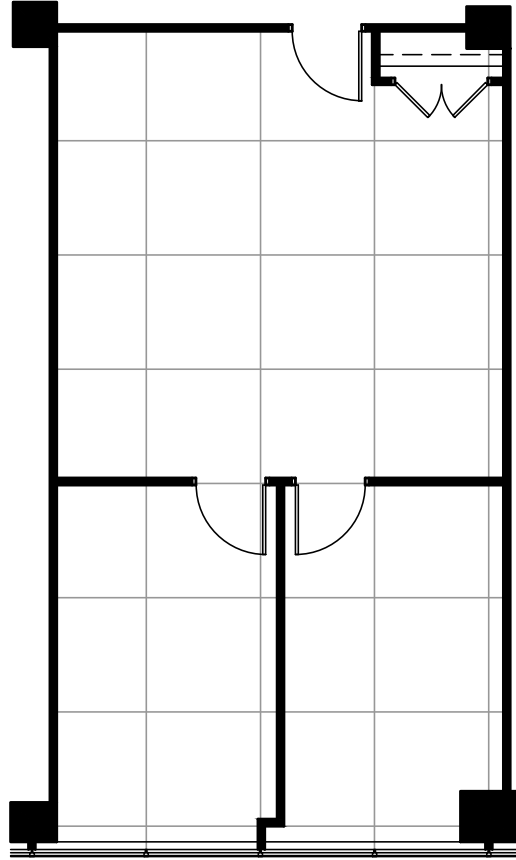

FIRST REAL PROPERTIES LIMITED

SKYWAY BUSINESS PARK
170 Attwell Drive
Toronto, Ontario

Suite 600 - 829 Sq. Ft. Rentable
Existing Space Plan

www.realpropertieslimited.com

YALE/170-180-190/170/18088/AS-BUILT PLAN

25-JULY-2018