



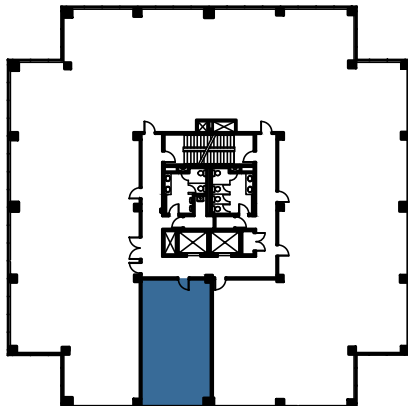

REAL

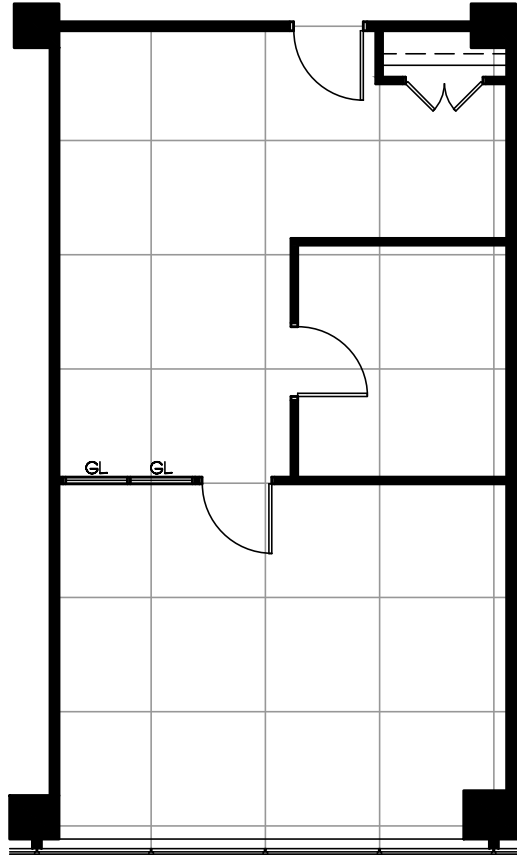

FIRST REAL PROPERTIES LIMITED

**SKYWAY BUSINESS PARK**  
170 Attwell Drive  
Toronto, Ontario

**Suite 600 - 829 sq.ft. Rentable**  
Existing Space Plan

[www.realpropertieslimited.com](http://www.realpropertieslimited.com)

YALE/170-180-190/170/16132/AS-BUILT PLAN

29-AUG-2016