



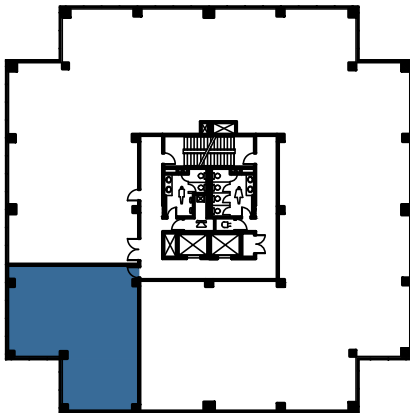

REAL

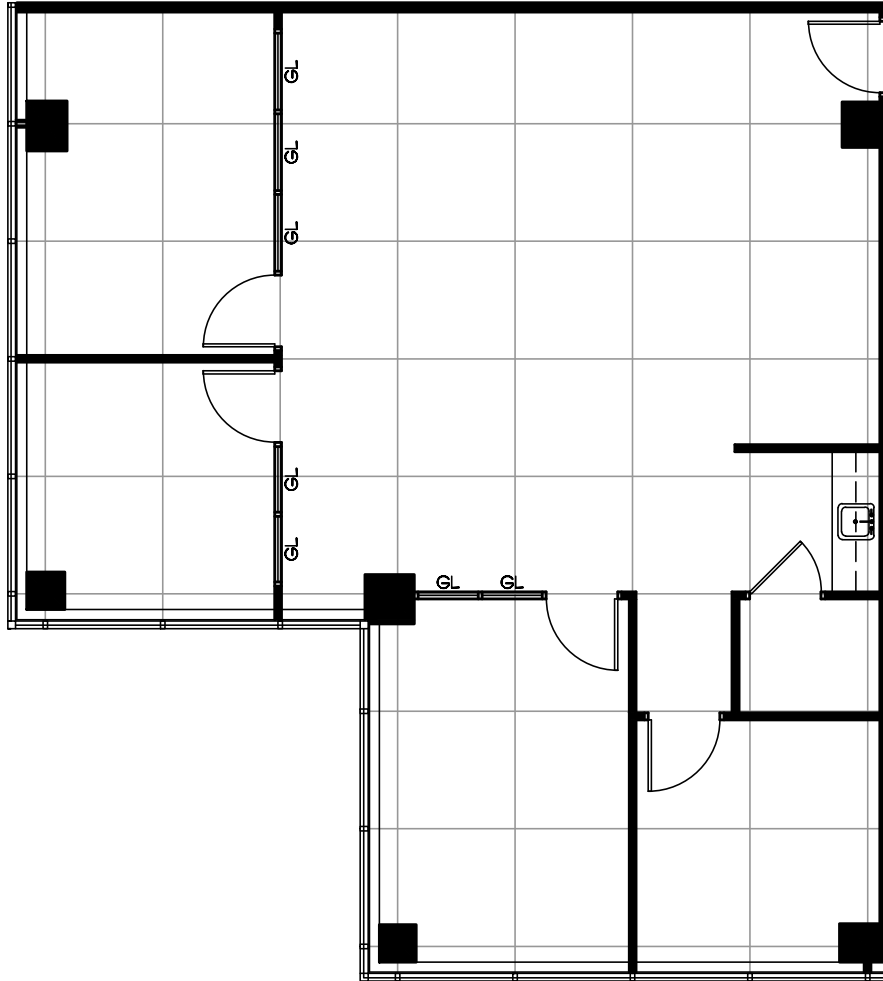

FIRST REAL PROPERTIES LIMITED

SKYWAY BUSINESS PARK
170 Attwell Drive
Toronto, Ontario

Suite 610 - 1,484 Sq. Ft. Rentable
Existing Space Plan

www.realpropertieslimited.com

YALE/170-180-190/170/14100/AS-BUILT PLAN 170-610

7-October-14