



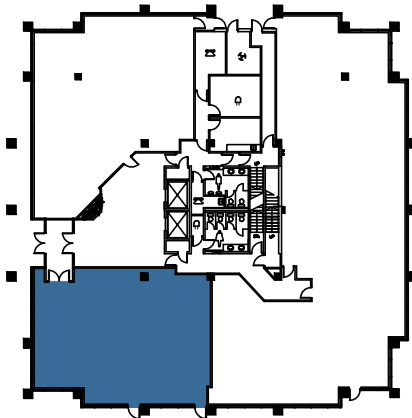

REAL

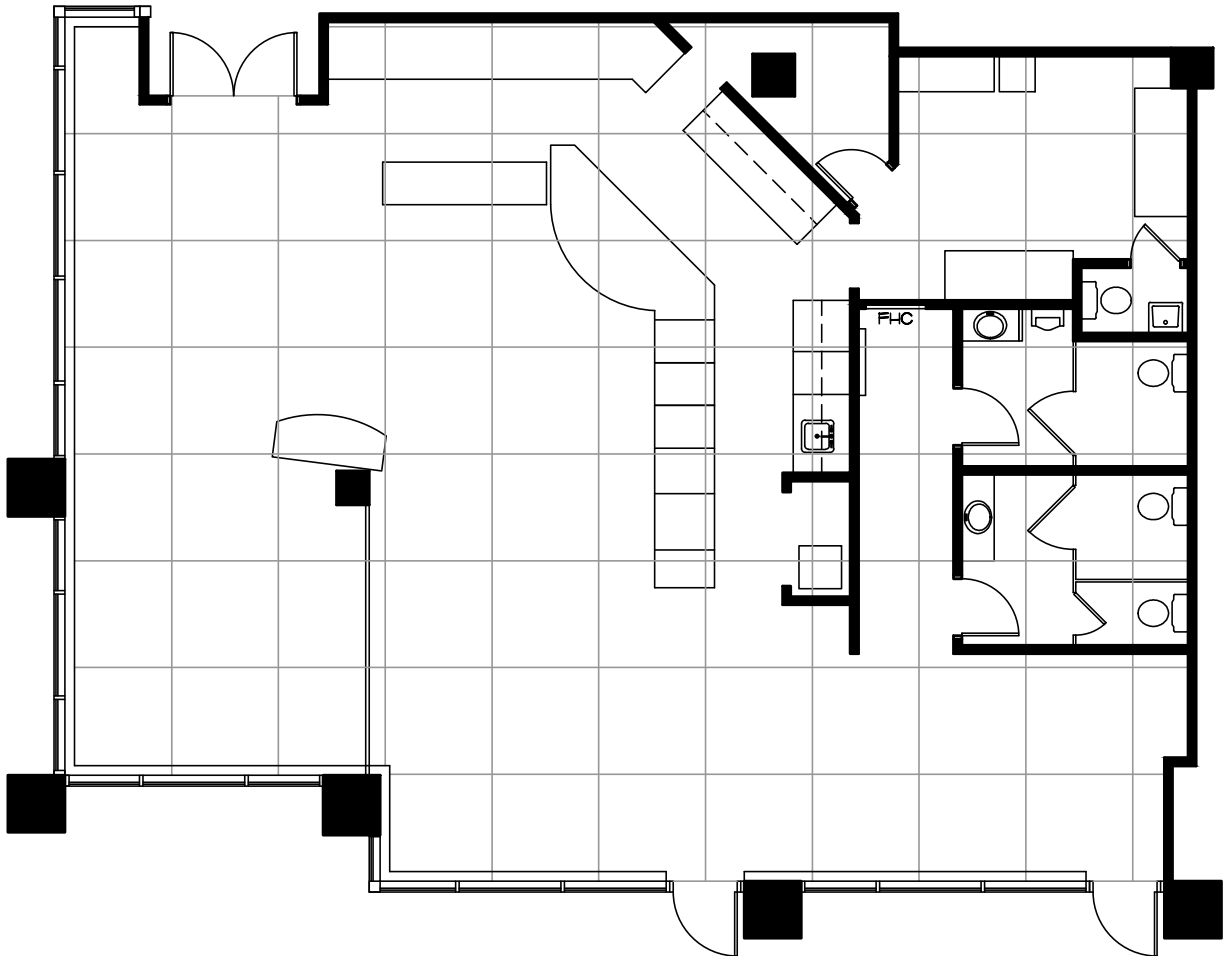

FIRST REAL PROPERTIES LIMITED

SKYWAY BUSINESS PARK

180 Attwell Drive
Toronto, Ontario

Suite 100 - 2227 Sq. Ft. Rentable

Existing Space Plan

www.realpropertieslimited.com

YALE/170-180-190/180/14070/AS-BUILT PLAN

21-May-14