



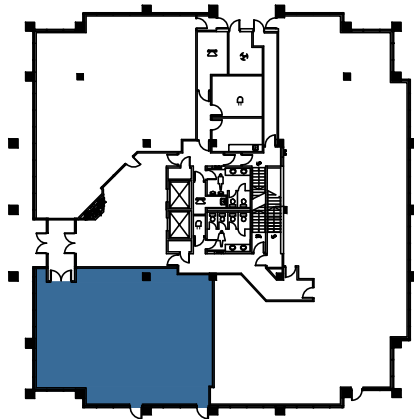

REAL

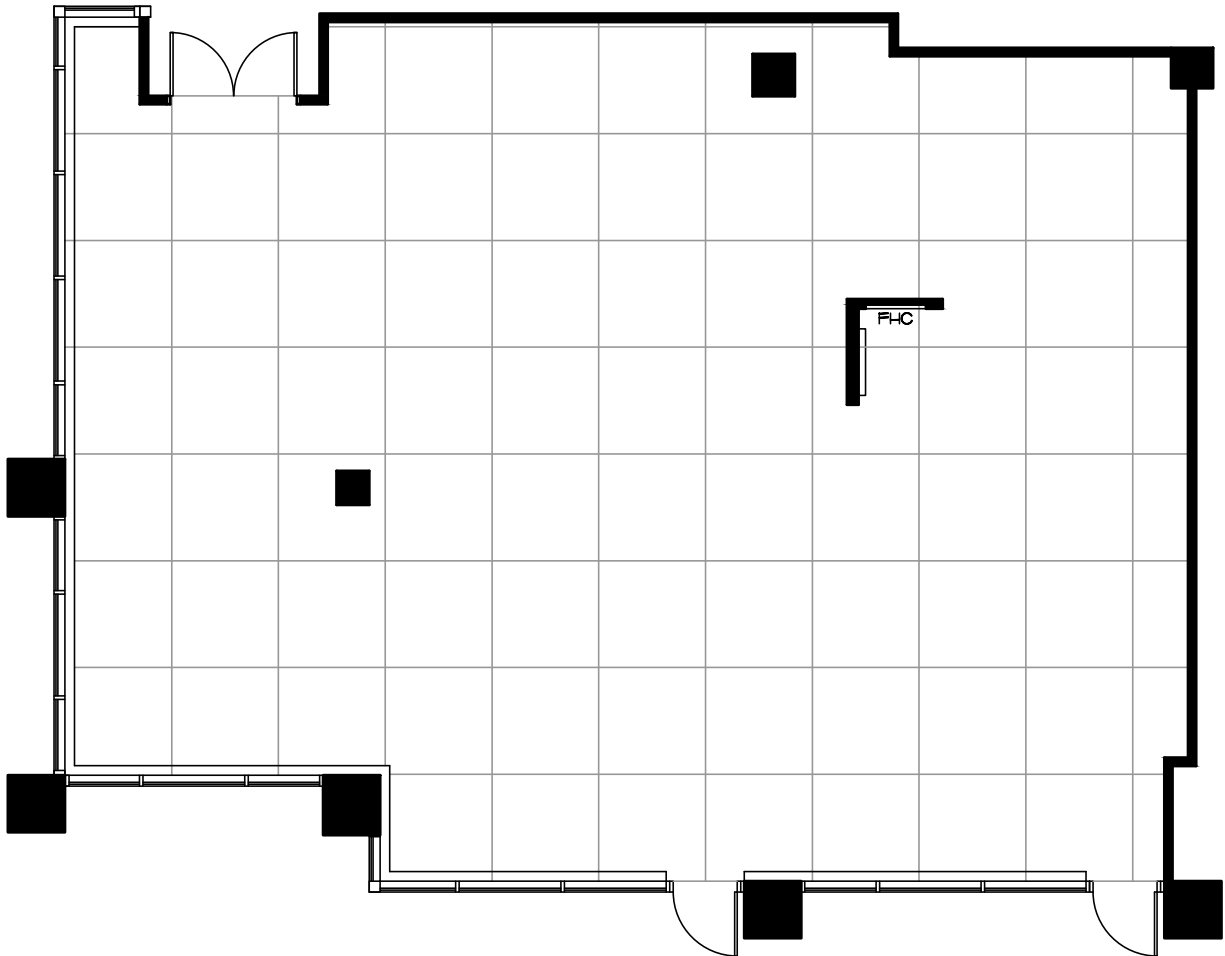

FIRST REAL PROPERTIES LIMITED

SKYWAY BUSINESS PARK
180 Attwell Drive
Toronto, Ontario

Suite 100 - 2227 Sq. Ft. Rentable
Existing Space Plan

www.realpropertieslimited.com
YALE/170-180-190/180/14190/AS-BUILT PLAN