



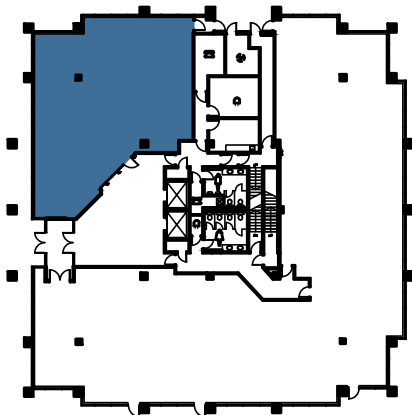

REAL

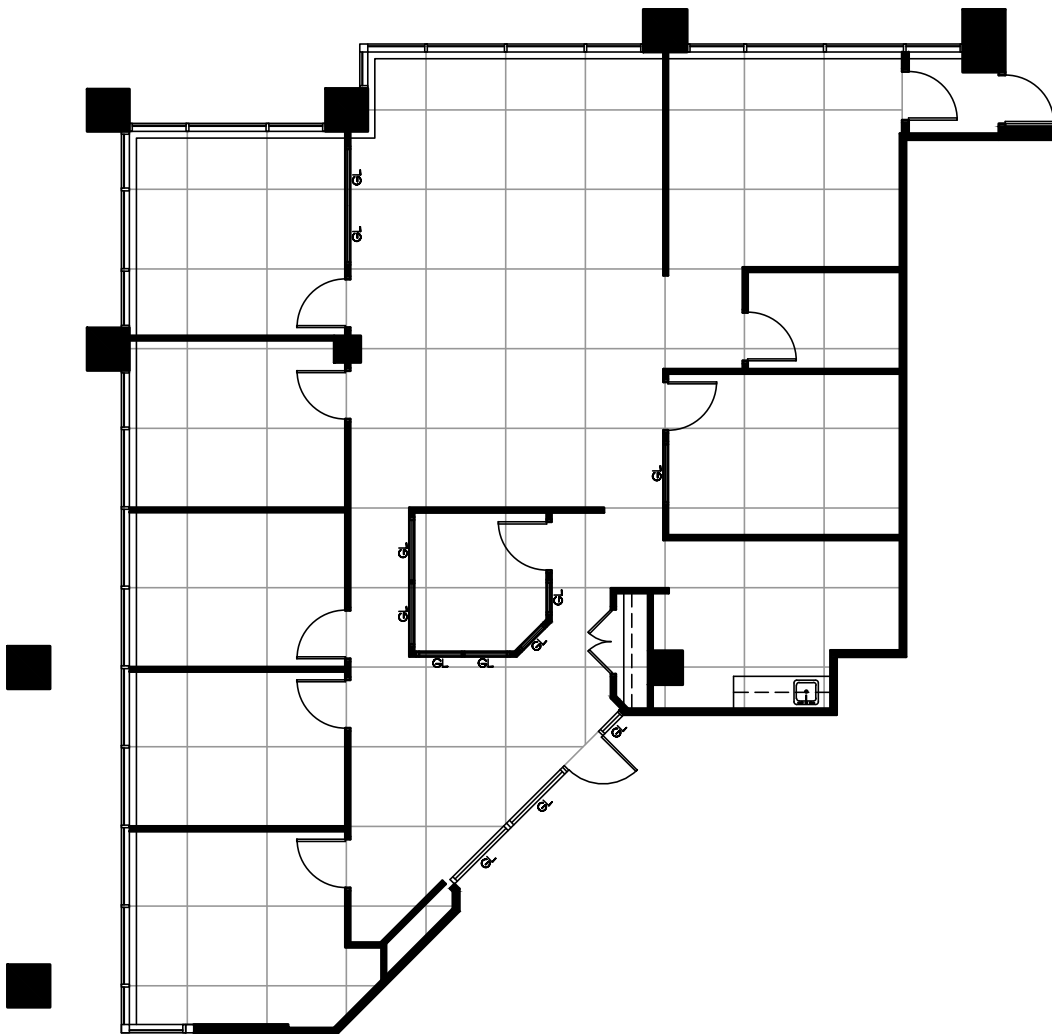

FIRST REAL PROPERTIES LIMITED

**SKYWAY BUSINESS PARK**  
180 Attwell Drive  
Toronto, Ontario

**Suite 101 - 2523 Sq. Ft. Rentable**  
Existing Space Plan

[www.realpropertieslimited.com](http://www.realpropertieslimited.com)

YALE/170-180-190/180/17010/AS-BUILT PLAN

16-JANUARY-17