





REAL

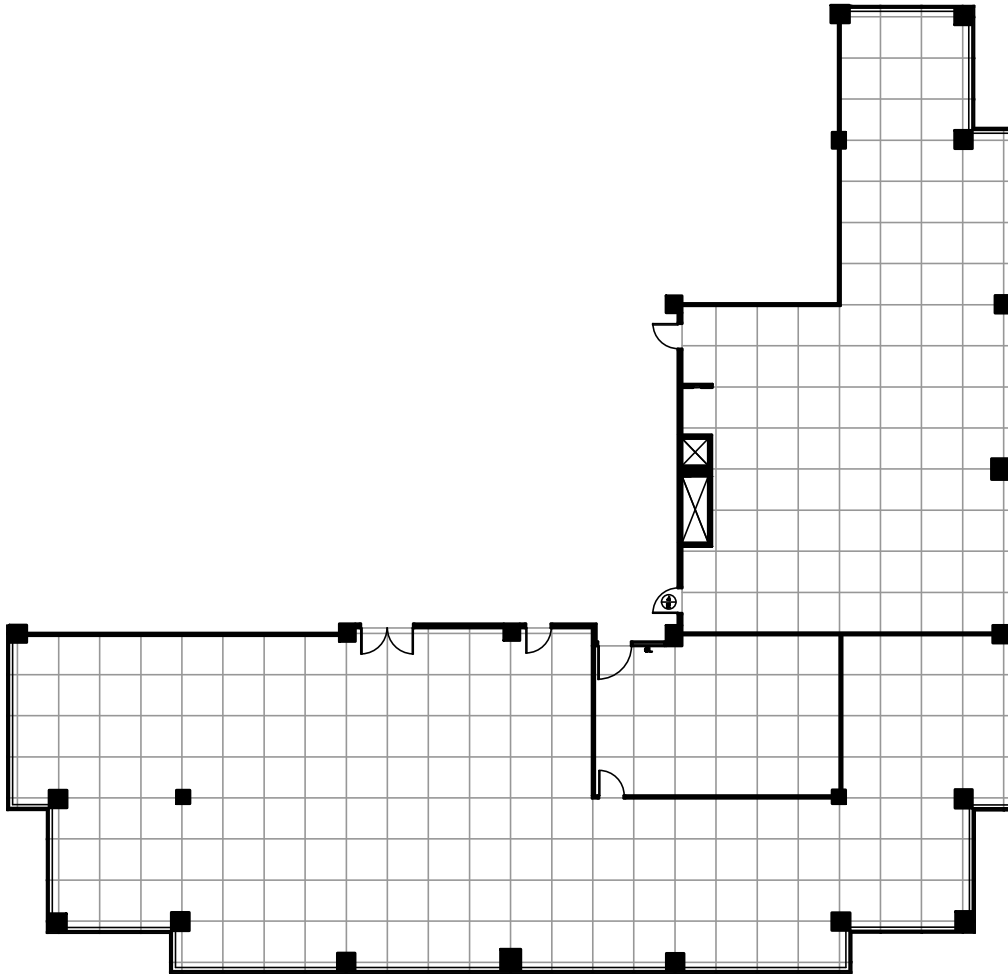

10 5 0 FEET 10

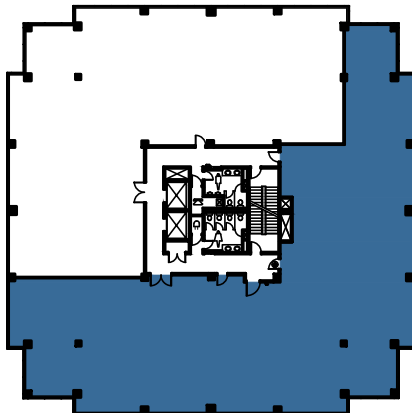

FIRST REAL PROPERTIES LIMITED

SKYWAY BUSINESS PARK
180 Attwell Drive
Toronto, Ontario

Suite 500 - 7,743 Sq. Ft. Rentable
Existing Space Plan

www.realpropertieslimited.com

YALE/170-180-190/180/14142/AS-BUILT PLAN 180-500

7-OCTOBER-14