



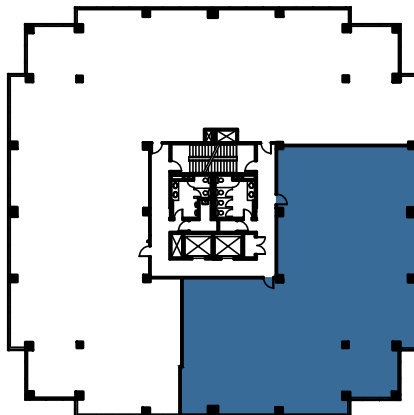

REAL

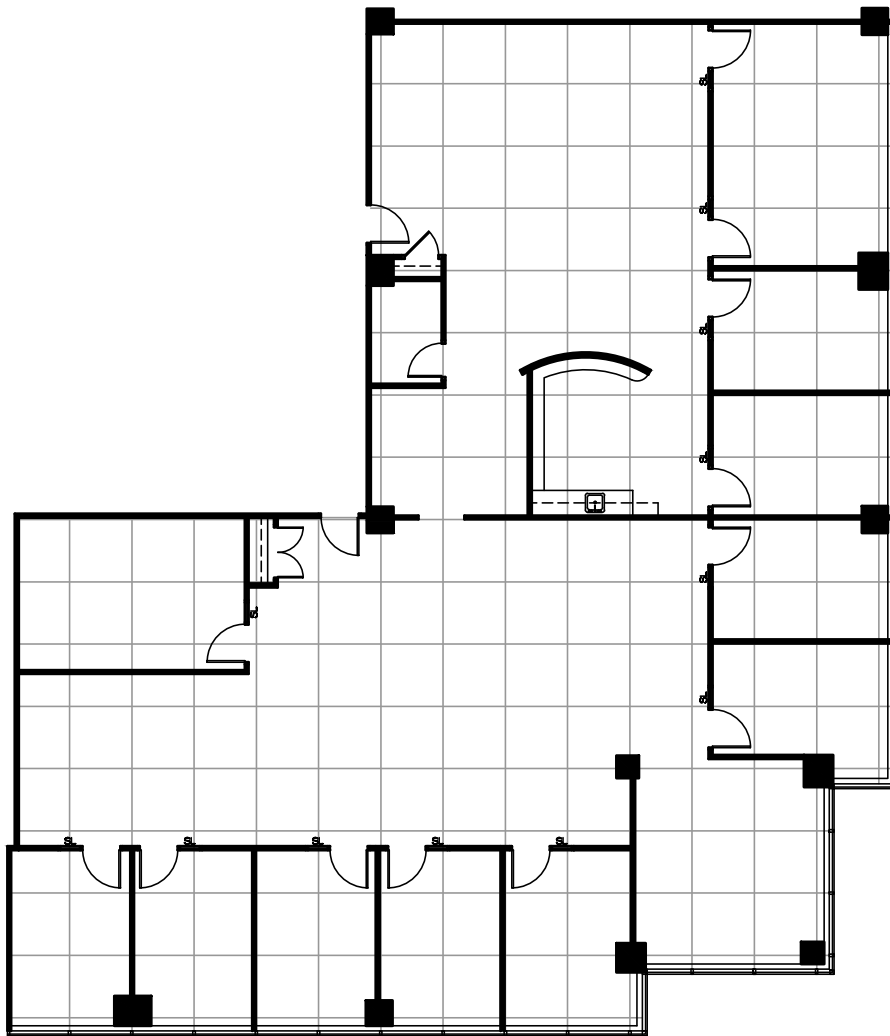

FIRST REAL PROPERTIES LIMITED

SKYWAY BUSINESS PARK
190 Attwell Drive
Toronto, Ontario

Suite 410 - 4,871 Sq. Ft. Rentable
Existing Space Plan

www.realpropertieslimited.com

YALE/170-180-190/190/17117/17117 - AS-BUILT PLAN 190-410

13-JUNE-17