



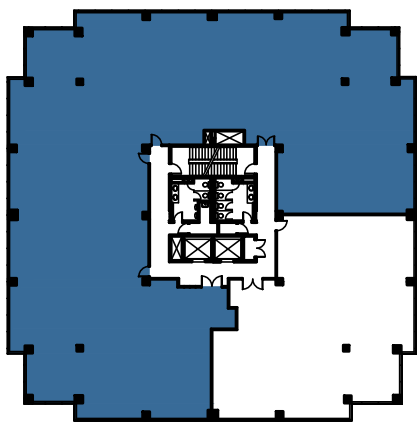

REAL

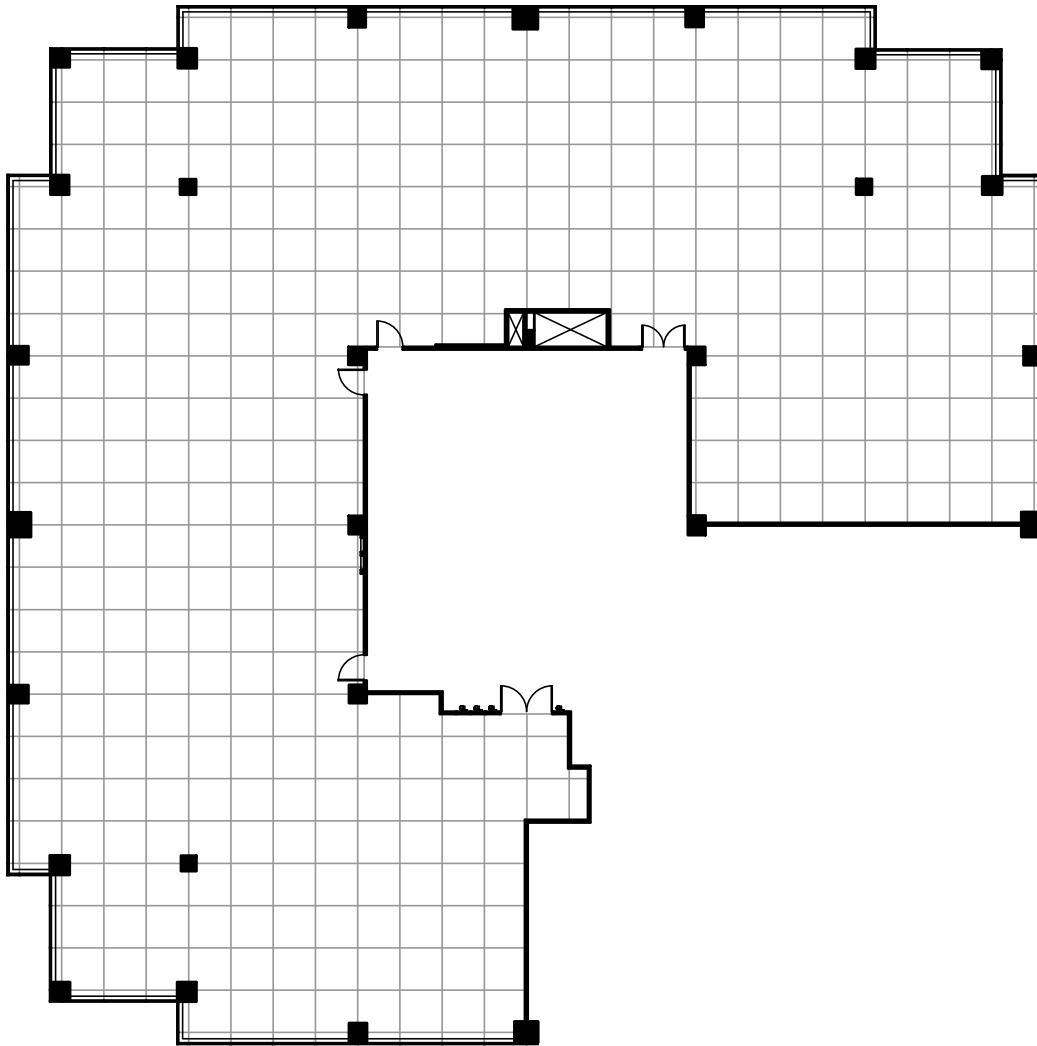

FIRST REAL PROPERTIES LIMITED

SKYWAY BUSINESS PARK
190 Attwell Drive
Toronto, Ontario

Suite 500 - 10,513 Sq. Ft. Rentable
Existing Space Plan

www.realpropertieslimited.com
YALE/170-180-190/190/16155/AS-BUILT PLAN