





REAL

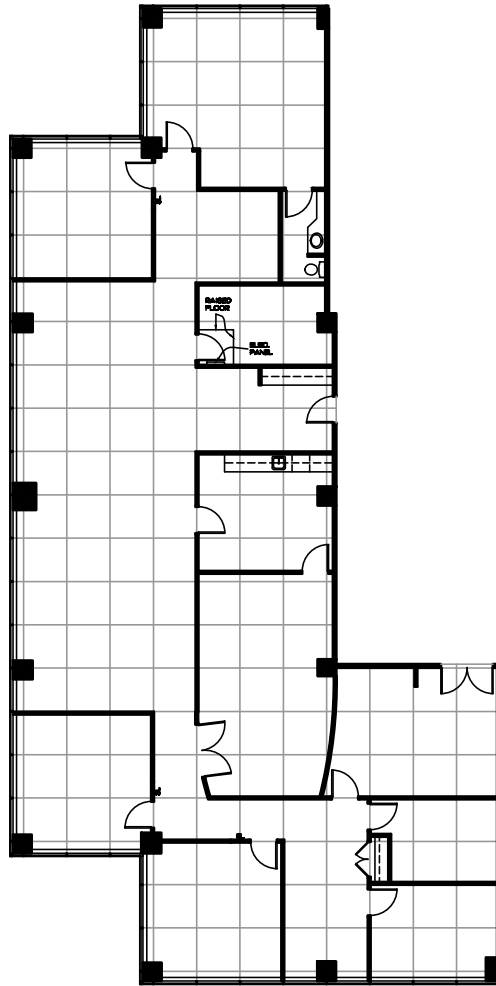

10 5 0 FEET 10

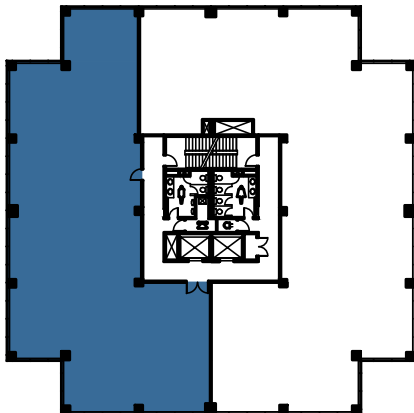

FIRST REAL PROPERTIES LIMITED

**SKYWAY BUSINESS PARK**  
**190 ATTWELL DRIVE**  
Toronto, Ontario

**Suite 600 - 4950 Sq. Ft. Rentable**  
Existing Space Plan

[www.realpropertieslimited.com](http://www.realpropertieslimited.com)  
YALE/170-180-190/190(12060)AS-BUILT PLAN