





REAL

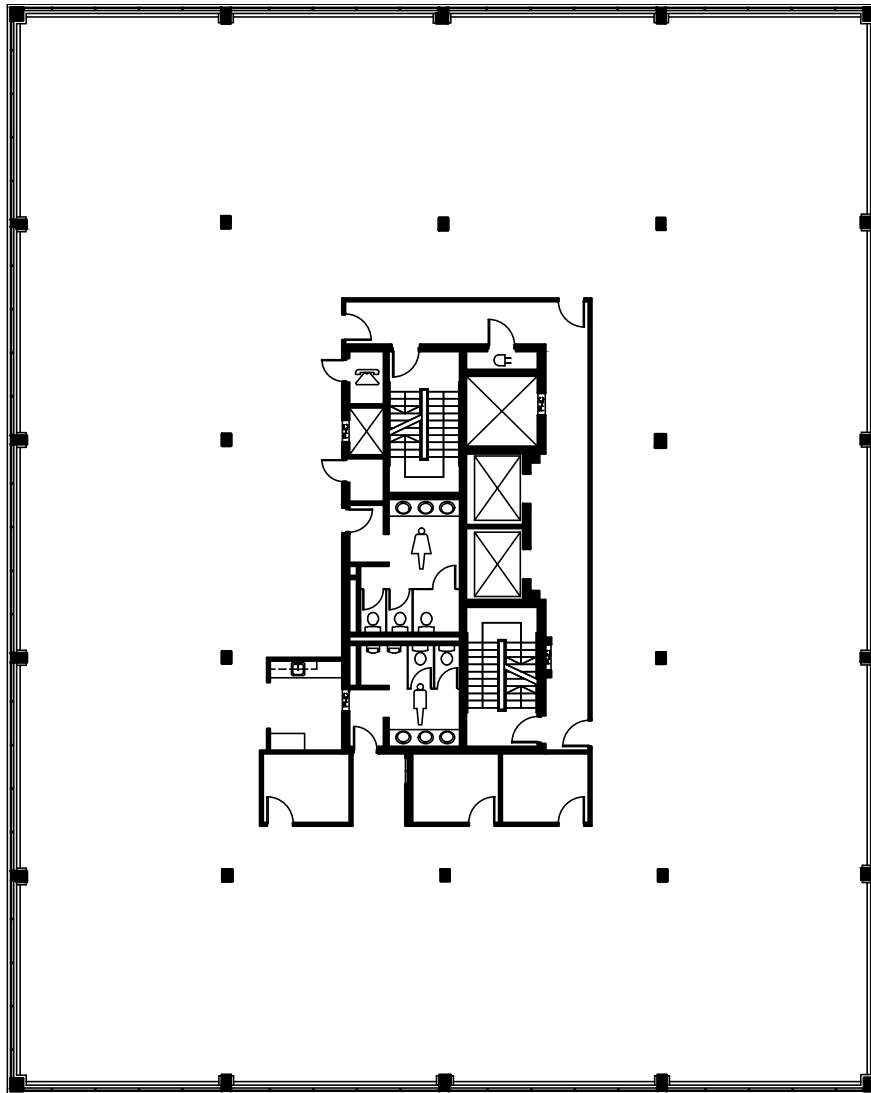

10 5 0 FEET 10

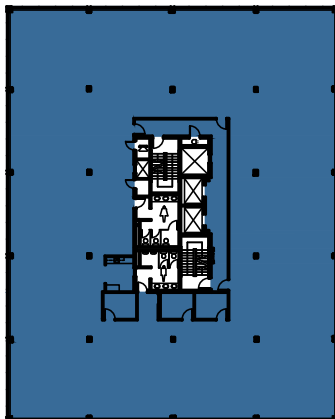

FIRST REAL PROPERTIES LIMITED

SKYWAY CORPORATE CENTRE

10 Kelfield Street,
Etobicoke, Ontario

Fifth Floor - 12,350 Sq. Ft. Rentable

Existing Space Plan

www.realpropertieslimited.com

YALE/10KELFIELD(13058)BASE-5th)AS-BUILT-NEW TEMPLATE

10-Dec-13