





REAL

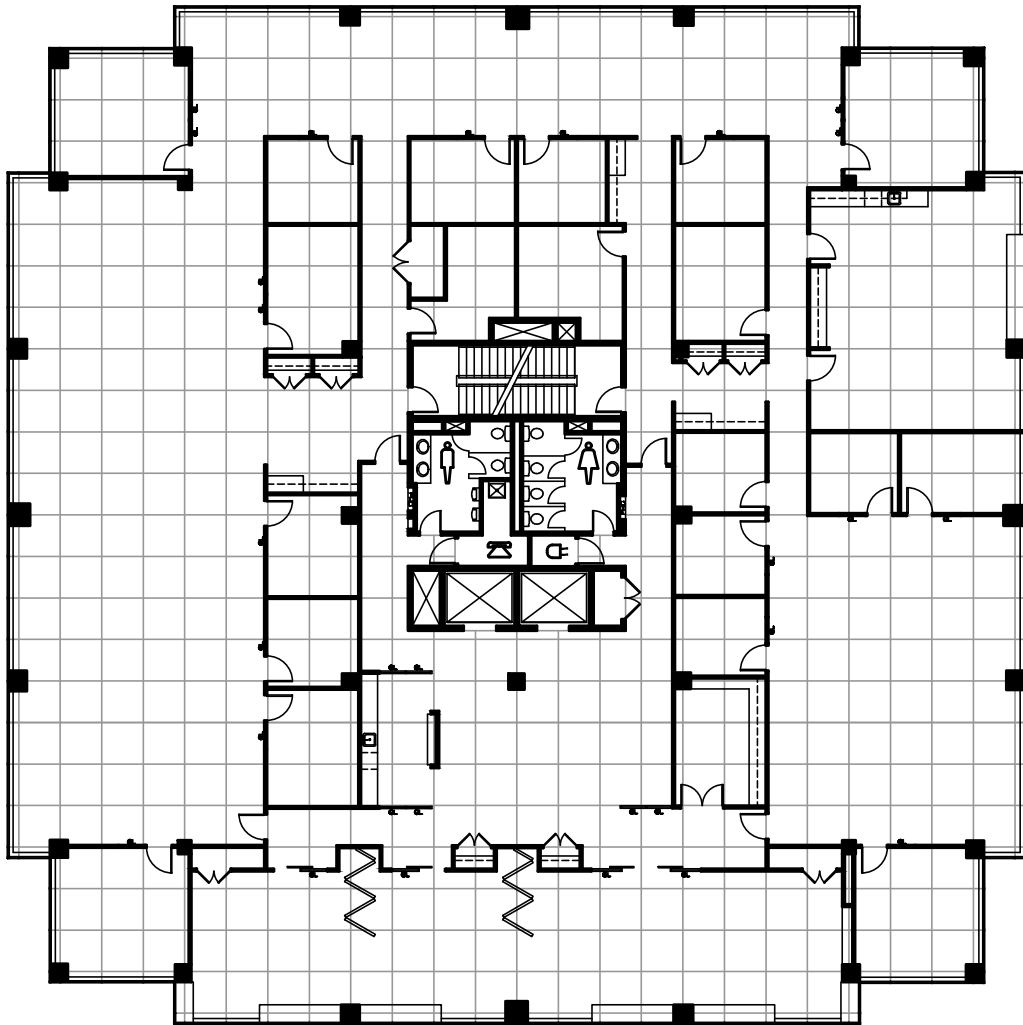

10 5 0 FEET 10

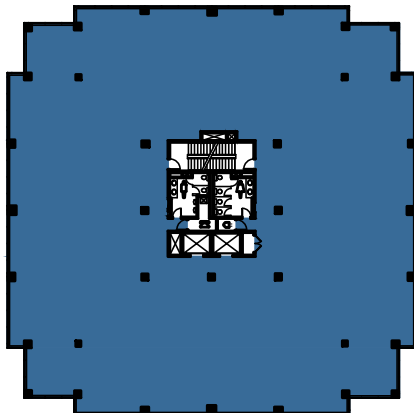

FIRST REAL PROPERTIES LIMITED

SKYWAY BUSINESS PARK
170 Attwell Drive
Toronto, Ontario

Suite 200 - 14,025 Sq. Ft. Rentable
Existing Space Plan

www.realpropertieslimited.com

YALE/170-180-190/17016153/AS-BUILT PLAN

24-OCTOBER-2016