



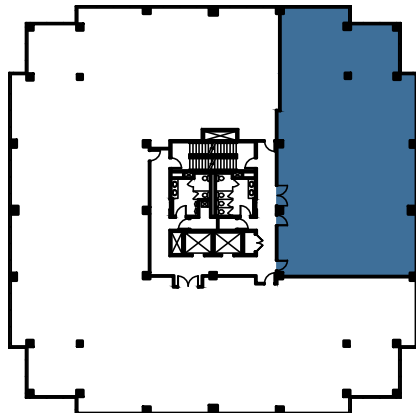

REAL

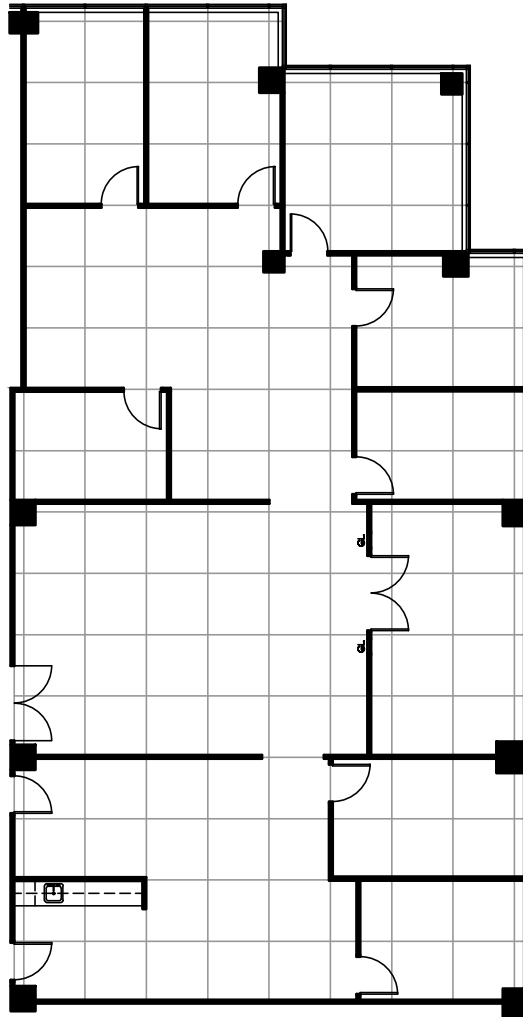

FIRST REAL PROPERTIES LIMITED

**SKYWAY BUSINESS PARK**  
170 Attwell Drive  
Toronto, Ontario

**Suite 370 - 3,573 Sq. Ft. Rentable**  
Existing Space Plan

[www.realpropertieslimited.com](http://www.realpropertieslimited.com)

YALE/170-180-190/170/18087/AS-BUILT PLAN - REVISED

10-APRIL-2019