




REAL

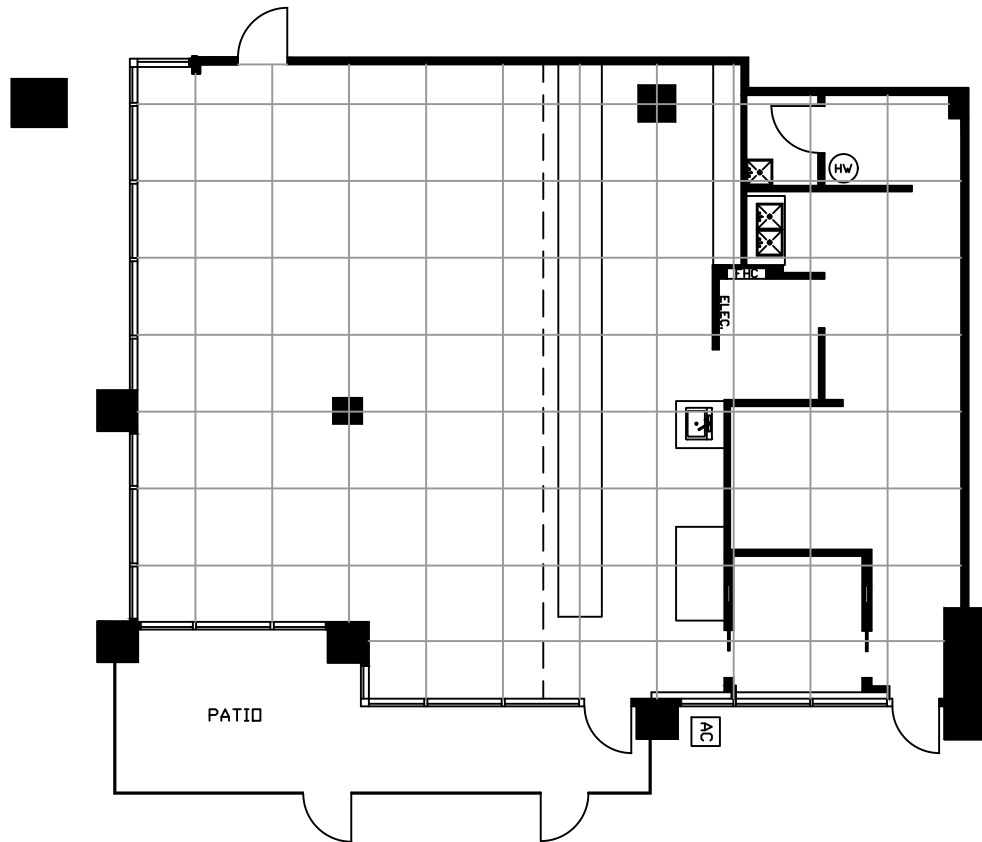

10 5 0 FEET 10

## FIRST REAL PROPERTIES LIMITED

### SKYWAY BUSINESS PARK

180 Attwell Drive  
Toronto, Ontario

**Suite 100 - 2227 Sq.Ft. Rentable**  
Existing Space Plan

[www.realpropertieslimited.com](http://www.realpropertieslimited.com)

YALE/170-180-190/170/18087/AS-BUILT PLAN - REVISED

1-OCTOBER-2020