



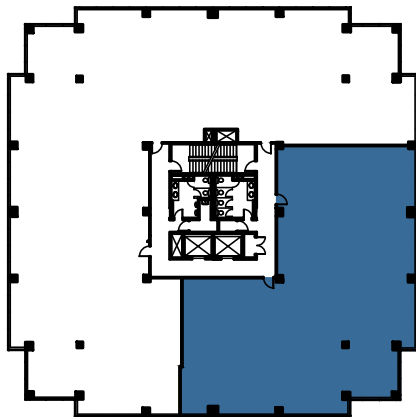

REAL

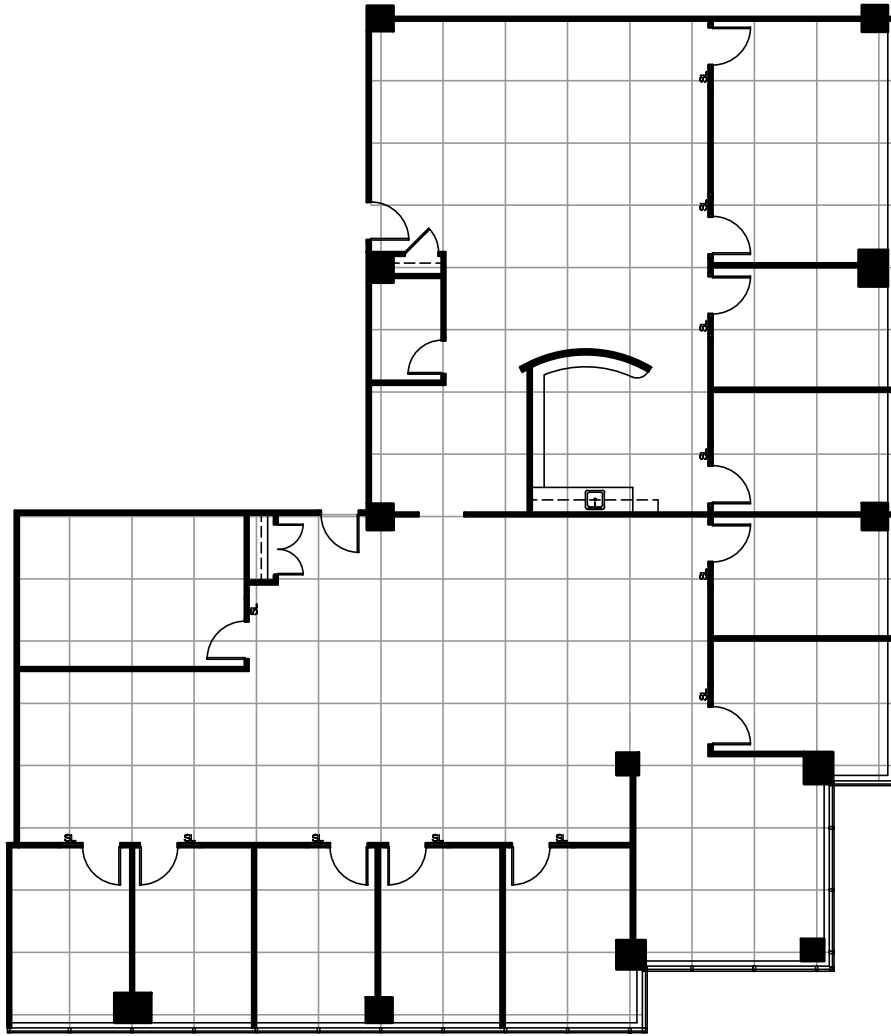

FIRST REAL PROPERTIES LIMITED

SKYWAY BUSINESS PARK
190 Attwell Drive
Toronto, Ontario

Suite 490 - 4,871 Sq. Ft. Rentable
Existing Space Plan

www.realpropertieslimited.com

YALE/170-180-190/190/1717/17117 - AS-BUILT PLAN 190-490

3-JULY-2019