





REAL

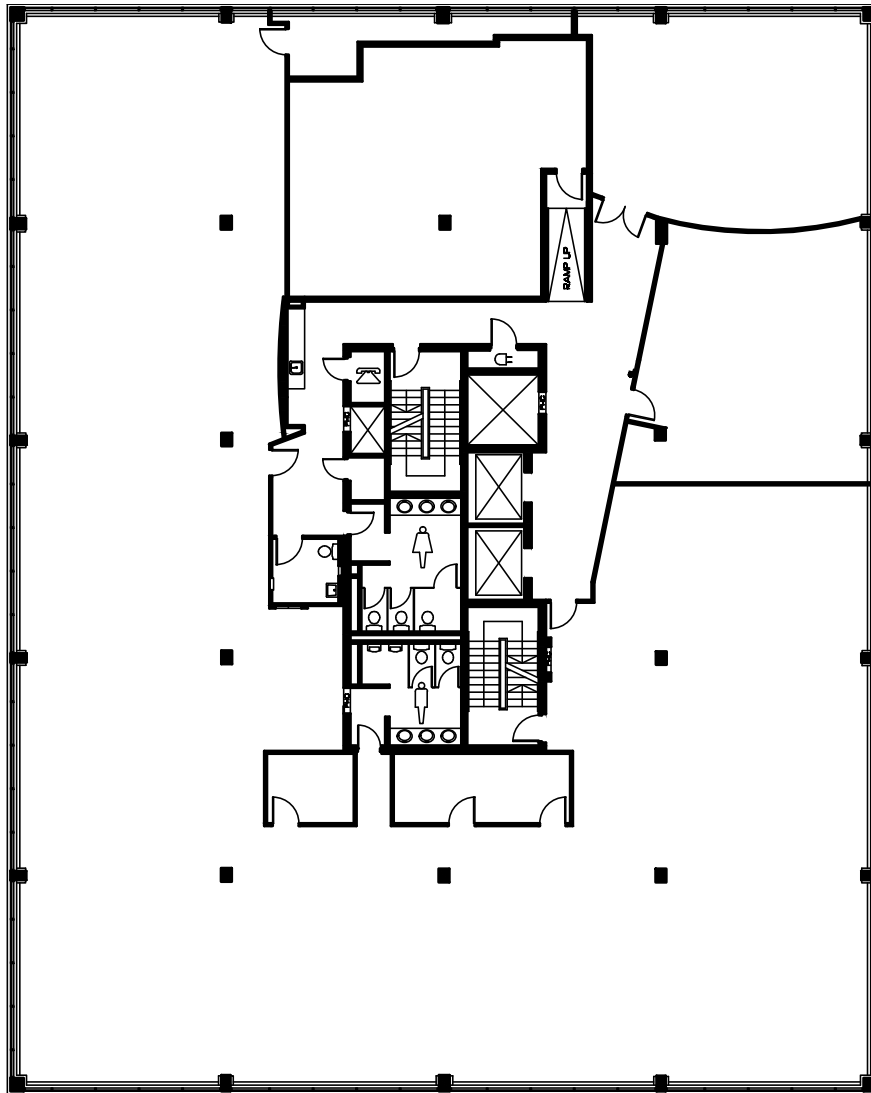

10 5 0 FEET 10

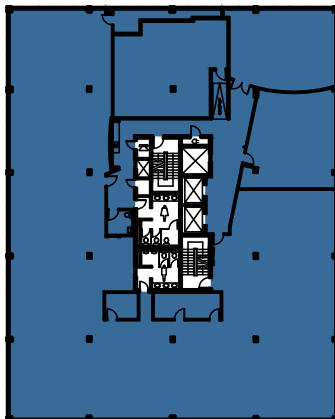

## FIRST REAL PROPERTIES LIMITED

### SKYWAY CORPORATE CENTRE

10 Kelfield Street,  
Etobicoke, Ontario

**Second Floor - 12,350 Sq. Ft. Rentable**  
Existing Space Plan

[www.realpropertieslimited.com](http://www.realpropertieslimited.com)

YALE\10KELFIELD\13058\BASE-2nd\AS-BUILT-NEW TEMPLATE

10-Dec-13