




REAL

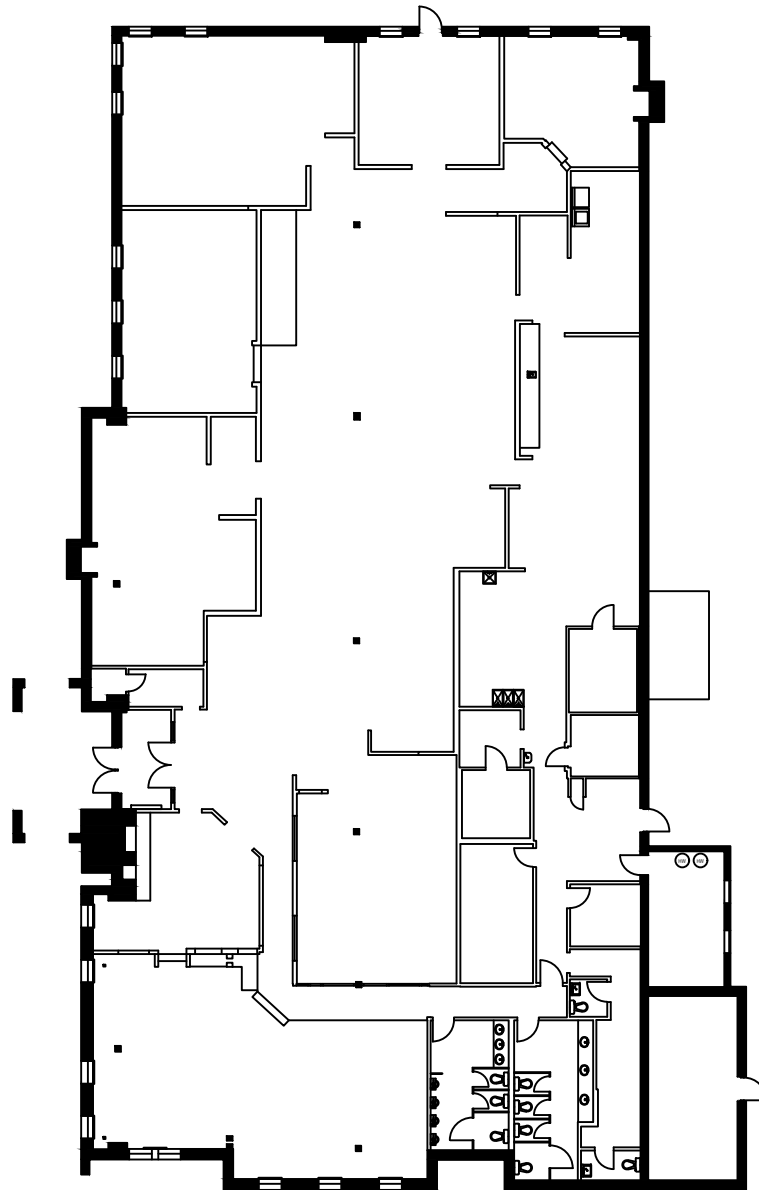

10 5 0 FEET 10

FIRST REAL PROPERTIES LIMITED

SKYWAY BUSINESS PARK
15 Carlson Court
Toronto, Ontario

11,855 Sq. Ft. Usable
Existing Space Plan

www.realpropertieslimited.com

YALE/170-180-190/170/18087/AS-BUILT PLAN - REVISED

26-AUGUST-2020