





REAL

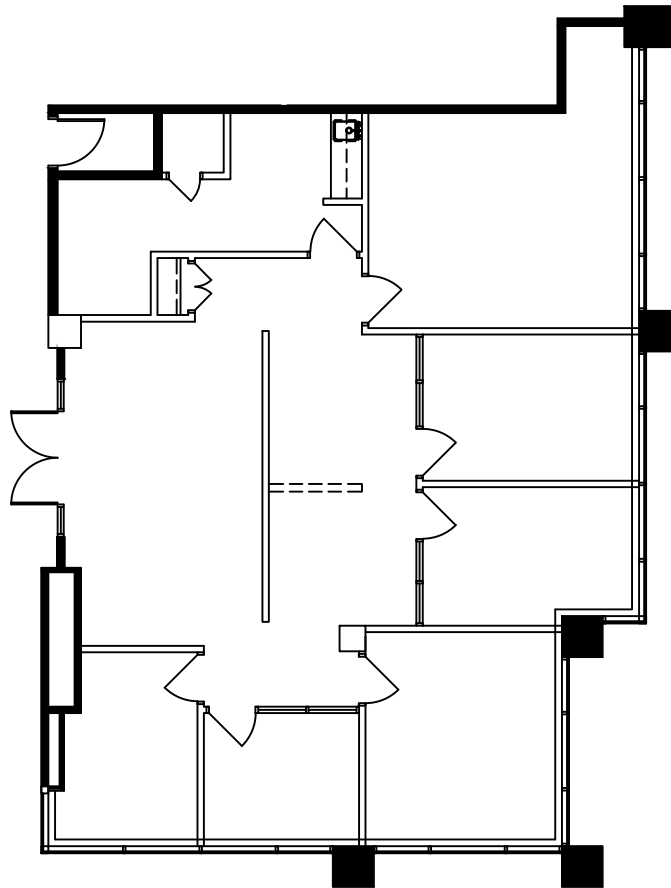

10 5 0 FEET 10

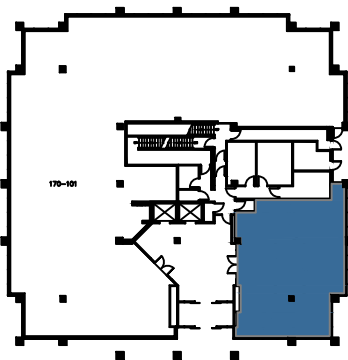

FIRST REAL PROPERTIES LIMITED

SKYWAY BUSINESS PARK
170 Attwell Drive
Toronto, Ontario

Suite 100 - 1814 Sq.Ft. Rentable
Existing Space Plan

www.realpropertieslimited.com

YALE/170-180-190/170/18087AS-BUILT PLAN - REVISED

1-OCTOBER-2020