



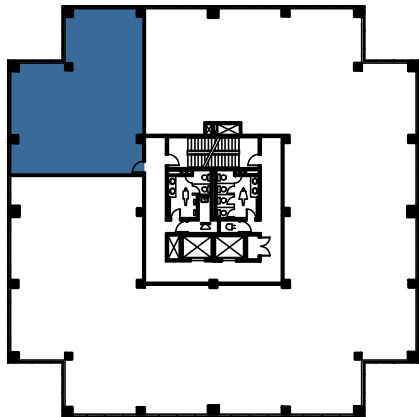

REAL

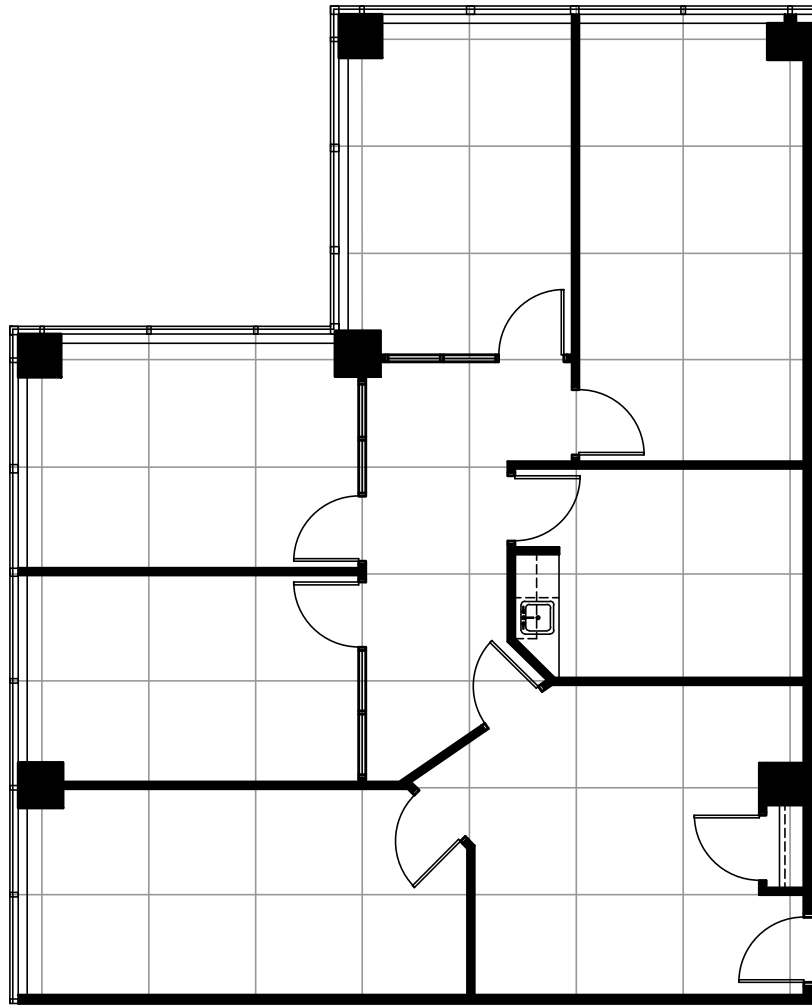

FIRST REAL PROPERTIES LIMITED

SKYWAY BUSINESS PARK
170 Attwell Drive
Toronto, Ontario

Suite 630 - 1691 Sq. Ft. Rentable
Existing Space Plan

www.realpropertieslimited.com
YALE/170-180-190/170/10084/AS-BUILT PLAN