



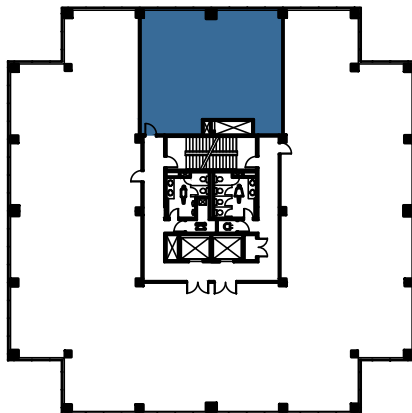

REAL

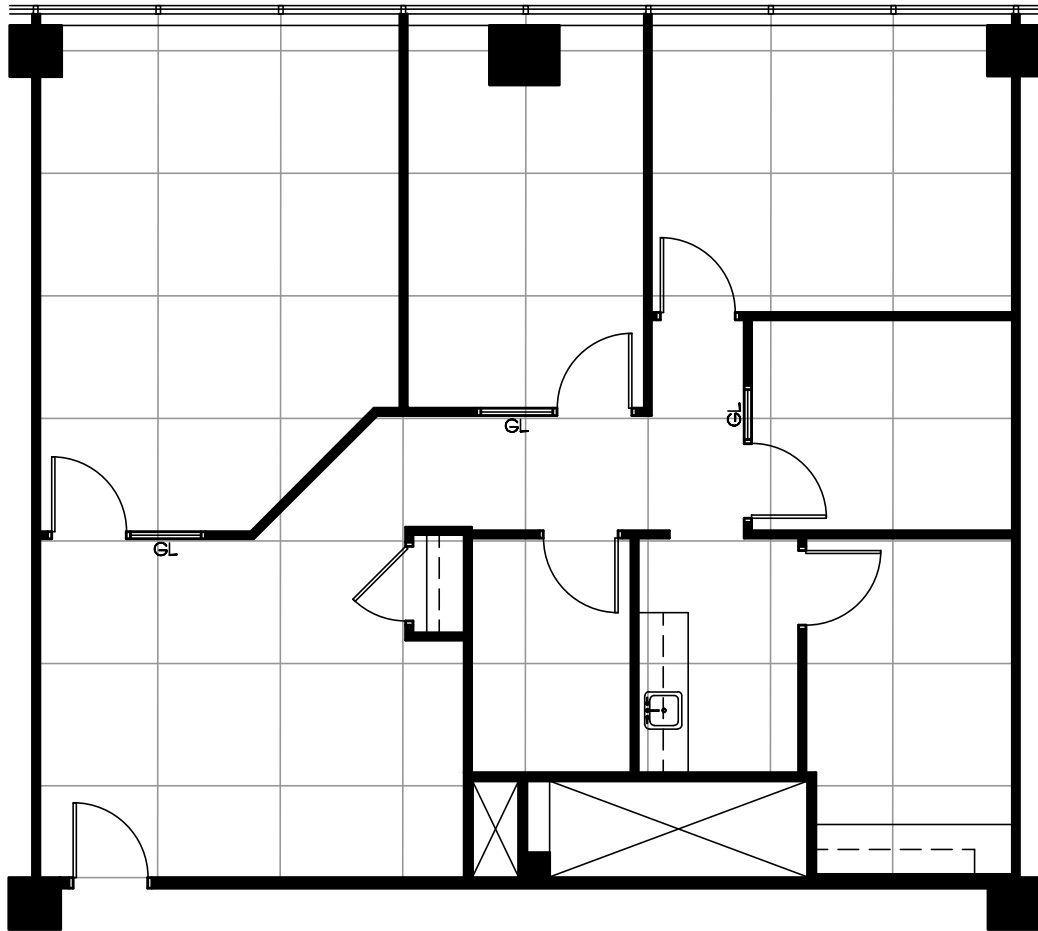

FIRST REAL PROPERTIES LIMITED

SKYWAY BUSINESS PARK
190 Attwell Drive
Toronto, Ontario

Suite 630 - 1521 Sq. Ft. Rentable
Existing Space Plan

www.realpropertieslimited.com

YALE/170-180-190/190/16176/AS-BUILT PLAN

28-NOVEMBER-16