





REAL

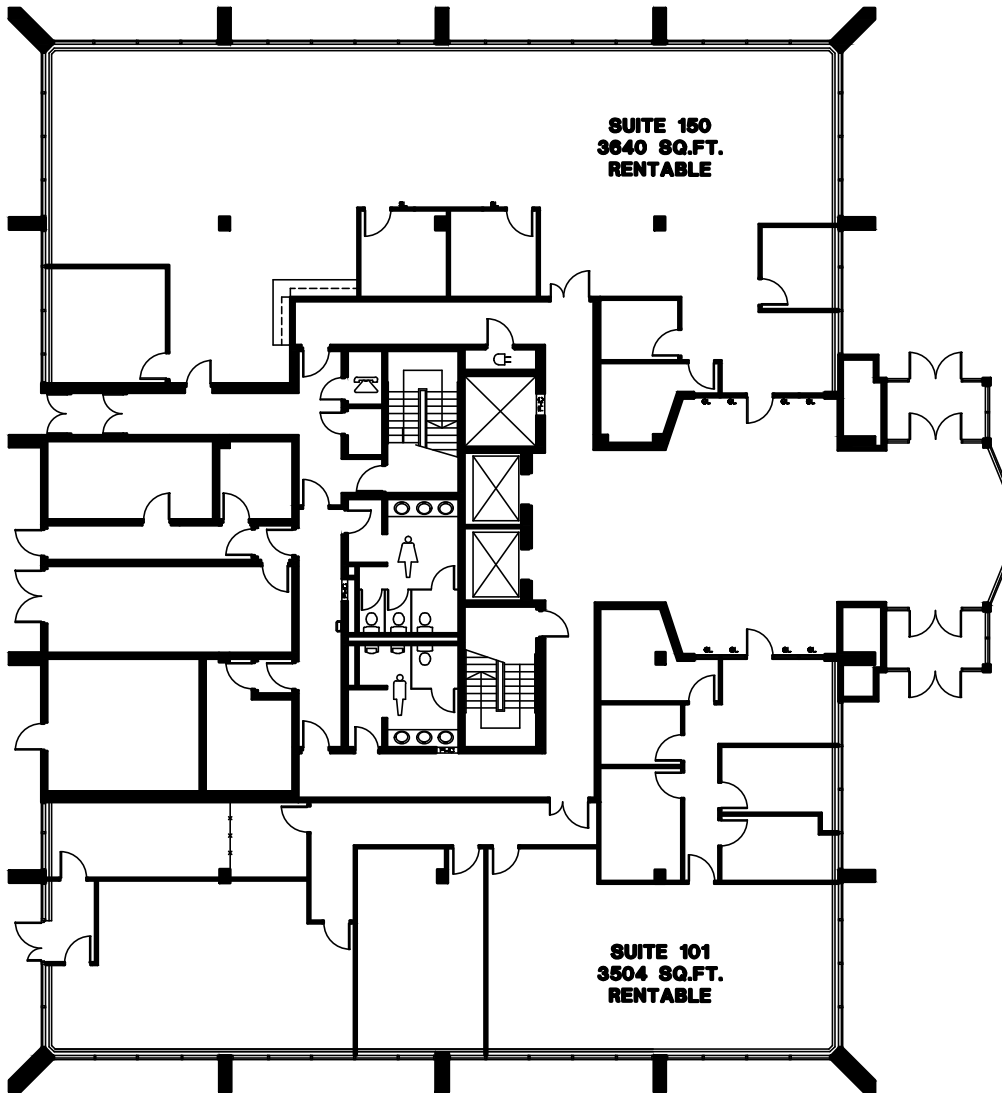

10 5 0 FEET 10

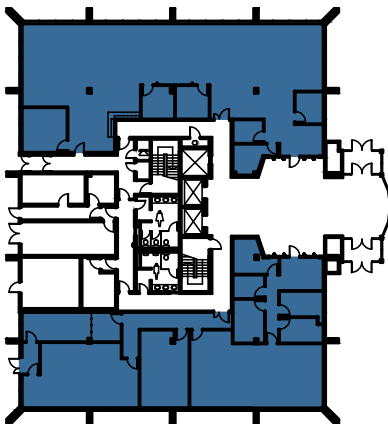

FIRST REAL PROPERTIES LIMITED

SKYWAY CORPORATE CENTRE

10 Kelfield Street,
Etobicoke, Ontario

Ground Floor - 7,144 Sq. Ft. Rentable
Existing Space Plan

www.realpropertieslimited.com

YALE/10KELFIELD/13058/BASE-GROUND-REVISED

07-Oct-14