



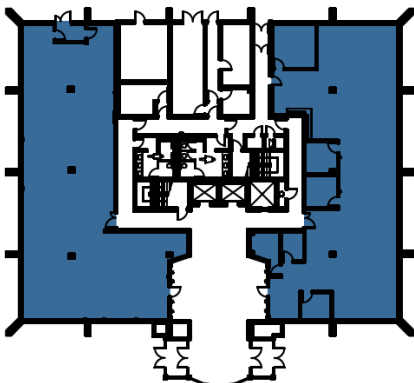

REAL

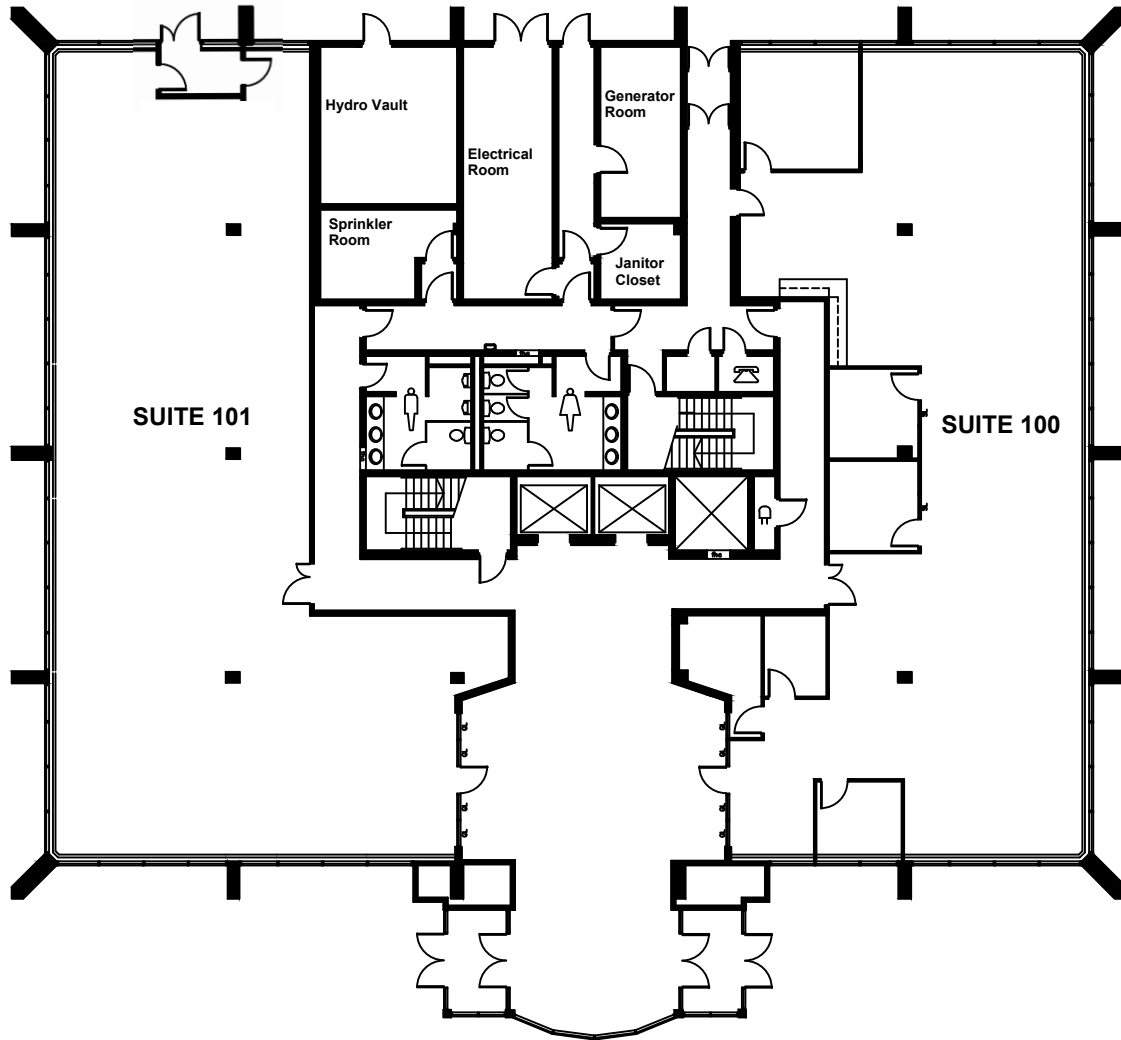

FIRST REAL PROPERTIES LIMITED

SKYWAY CORPORATE CENTRE

10 Kelfield Street
Etobicoke, Ontario

SUITE 100 - 3,640 Sq.Ft. Rentable

SUITE 101 - 3,504 Sq.Ft. Rentable

TOTAL GROUND FLOOR - 7,144 Sq. Ft. Rentable

www.realpropertieslimited.com

YALE/170-180-190/17016153/AS-BUILT PLAN

24-OCTOBER-2016