



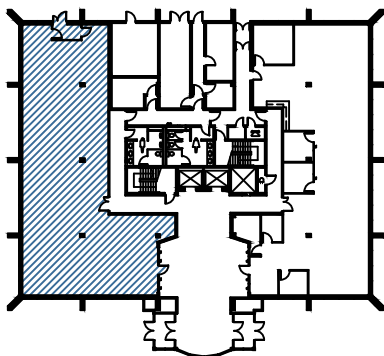

REAL

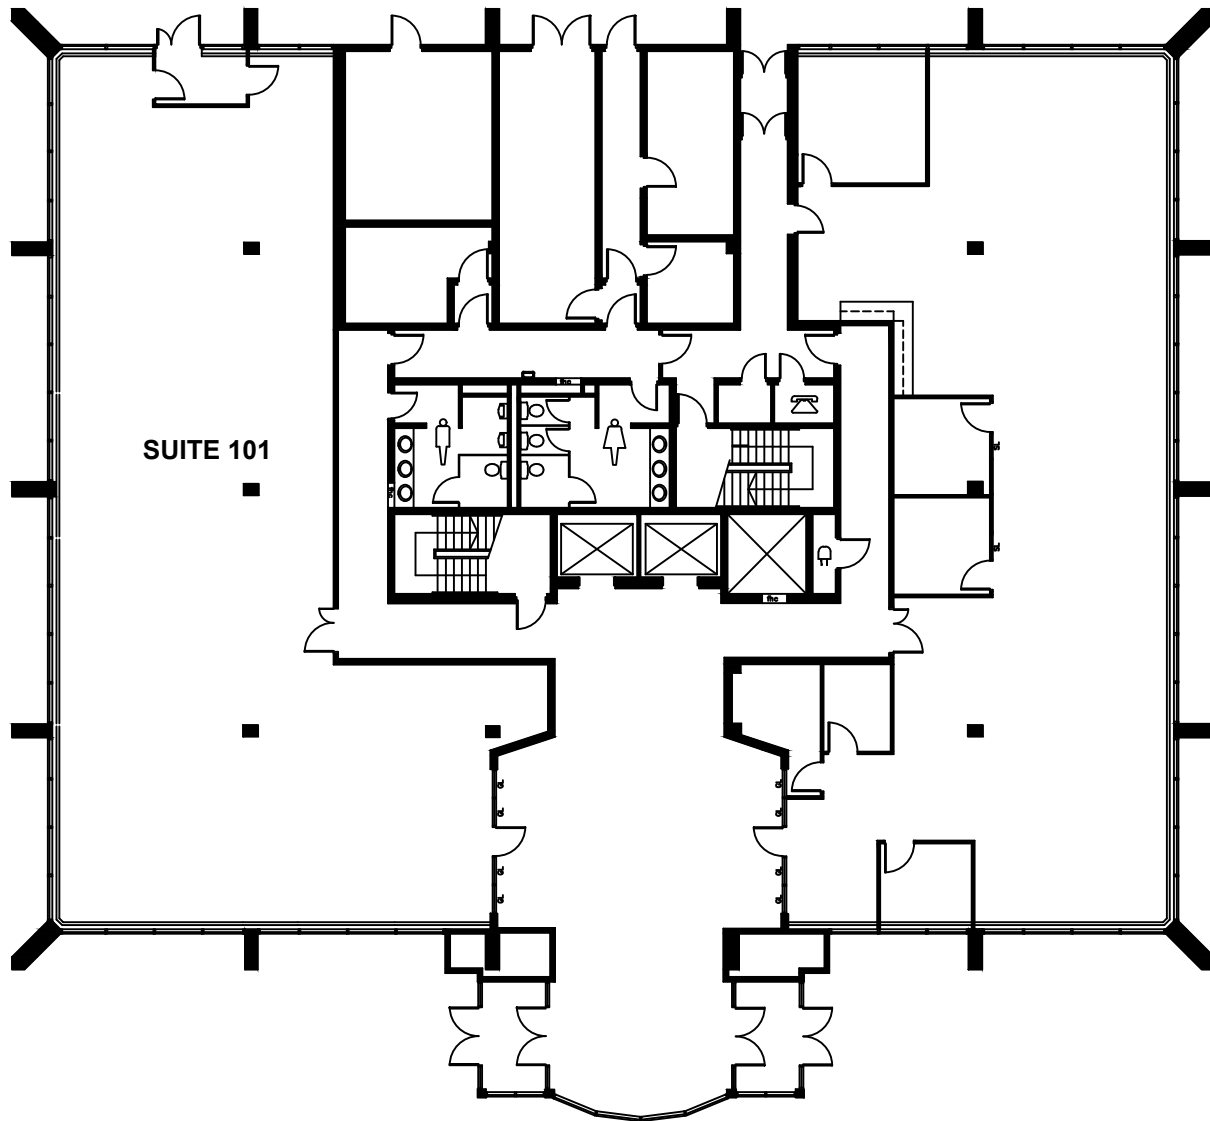

FIRST REAL PROPERTIES LIMITED

SKYWAY CORPORATE CENTRE

10 Kelfield Street
Etobicoke, Ontario

SUITE 101 - 3,504 Sq. Ft. Rentable
Existing Space Plan

www.realpropertieslimited.com

YALE/170-180-190/170/16153/AS-BUILT PLAN

24-OCTOBER-2016