





REAL

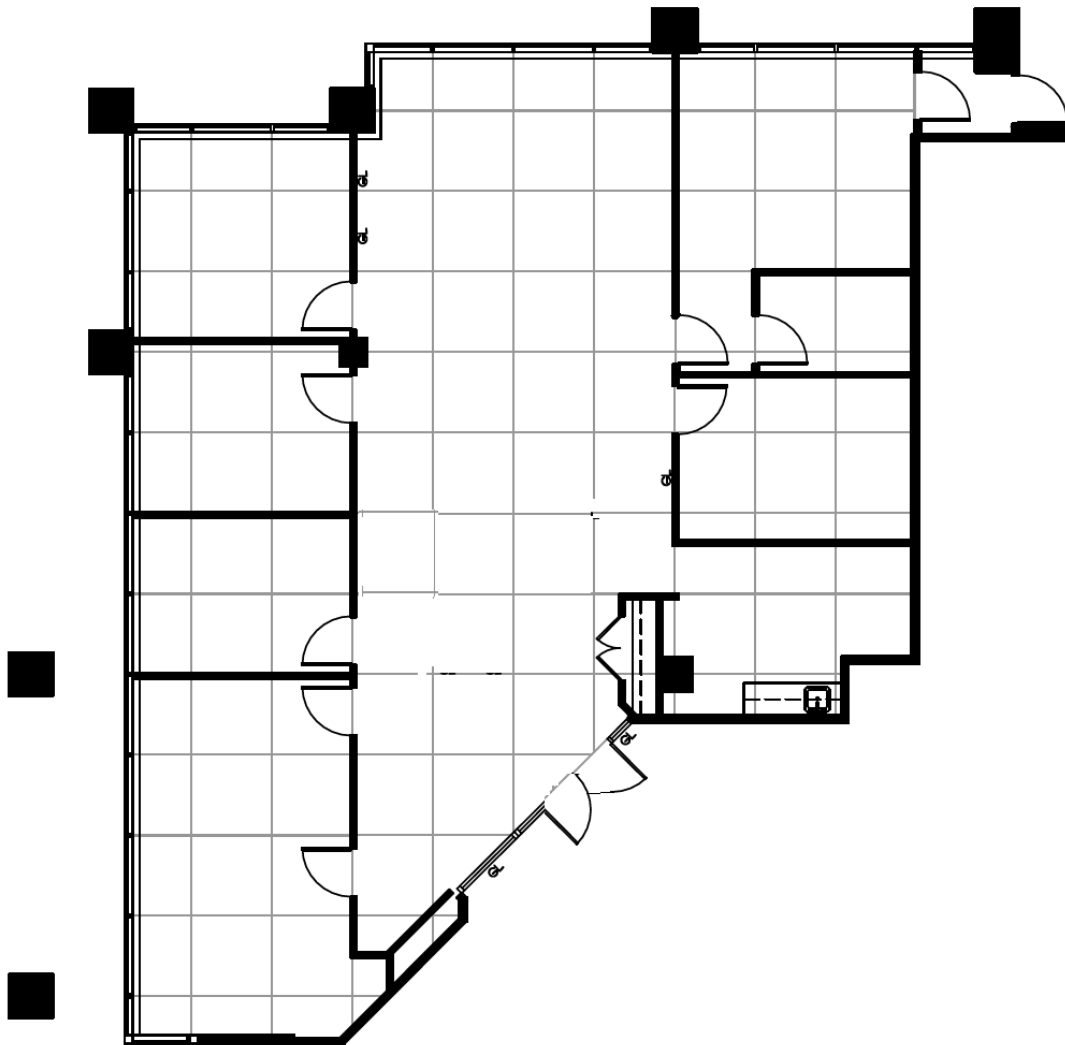

10 5 0 FEET 10

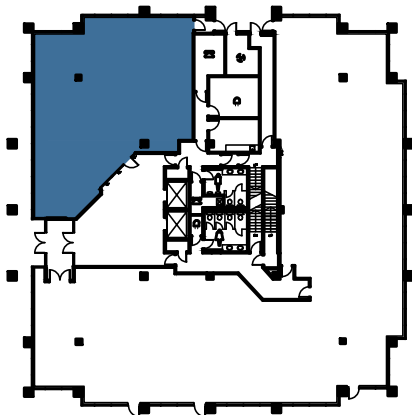

FIRST REAL PROPERTIES LIMITED

SKYWAY BUSINESS PARK

180 Attwell Drive
Toronto, Ontario

Suite 110 - 2523 Sq. Ft. Rentable
Existing Space Plan

www.realpropertieslimited.com

YALE/170-180-190/180/17010/AS-BUILT PLAN

16-JANUARY-17